
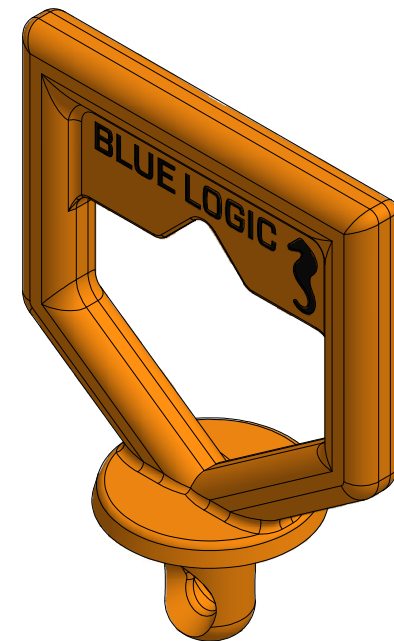
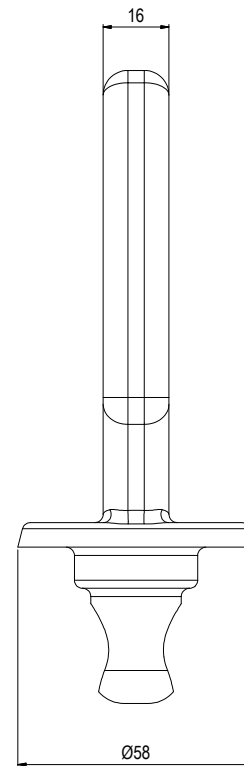


NOTE: 1
 DESIGN CODE:
 N/A

NOTE: 2
 TECHNICAL CLASSIFICATION:
 Article Type: 002-ROV handels
 Main Group: 2.01. Stab-Handel
 Intermediate Group: 2.7.2. D-Handle
 Sub Group: 2.7.47.2. Permanent

NOTE: 3
 INTERFACE INFORMATION:

Pressure Rating Bar: N/A
 Material: UNS J93404 Casted Super Duplex
 Weight: 0,9 kg
 Volume: 119,1 cm³
 Surface Area: 308 cm²
 Hydraulic: N/A
 Mechanical: N/A
 Electrical: N/A
 Com. & Protocol: N/A

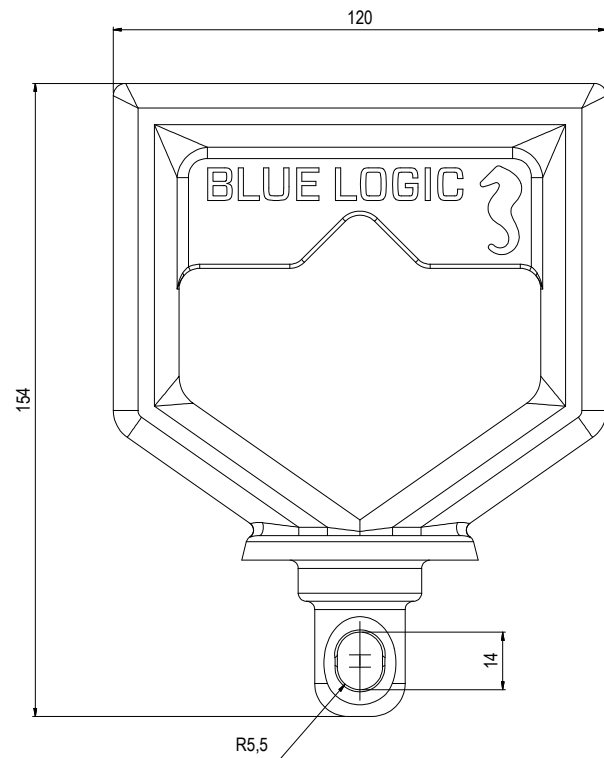

03	23.1.2015	8-ASB (As-Built)		WTJ	LGH	WTJ
01	3.10.2011	7-IFC (Issued for Construction)		LGH	NA	NA
Rev.	Date	Reason for issue	Revision change	Made	Chkd	Appr.



Dwg Scale:	NTS
Dwg Prop:	
Dwg Format:	A3

Drawing title:	D-Handle
Drawing number:	PA0049
Rev.	03