
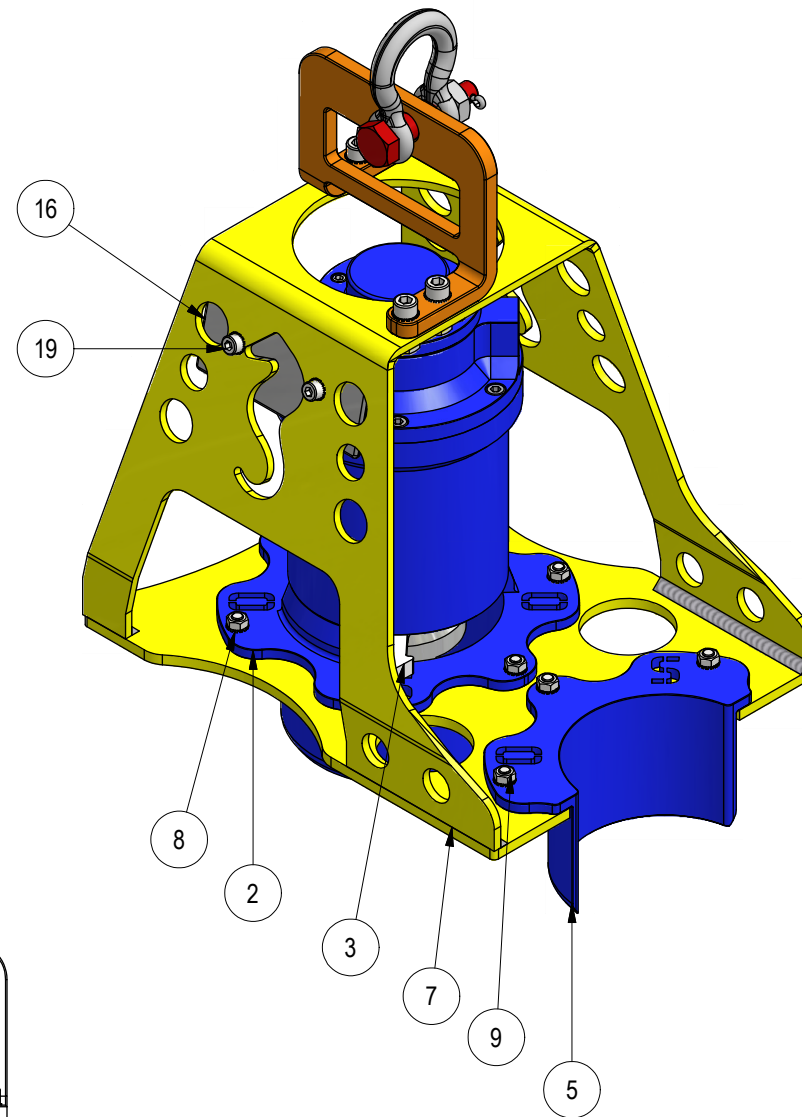
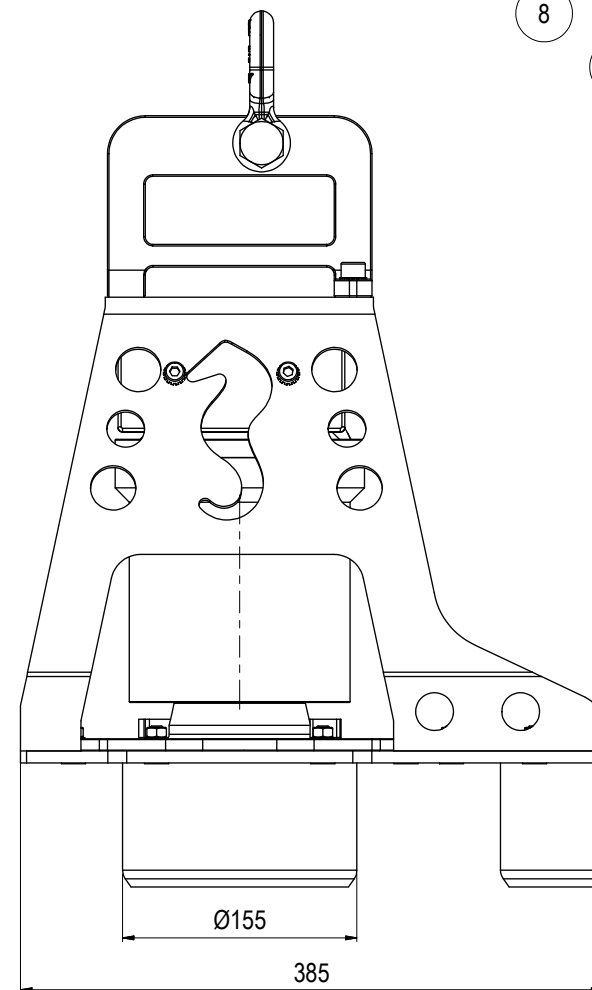
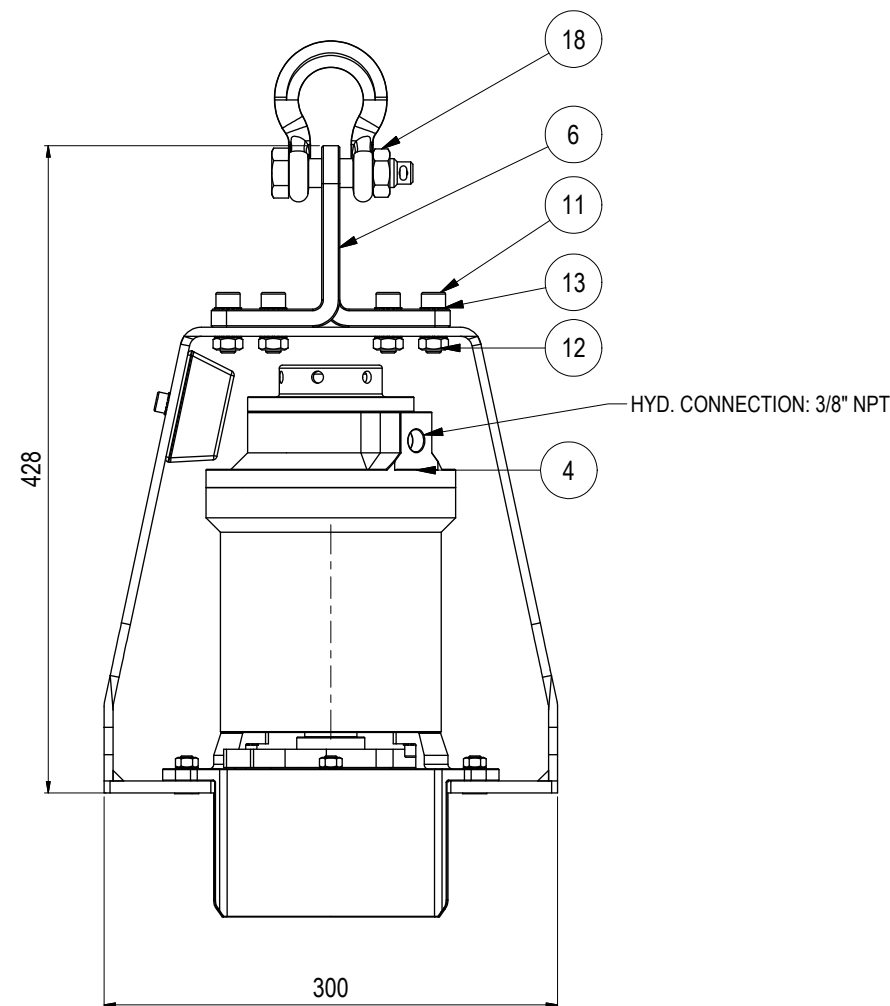


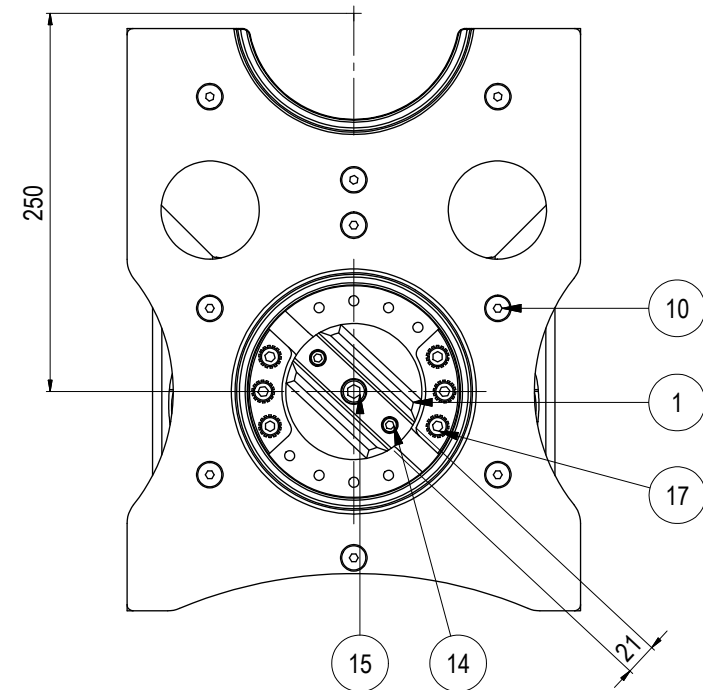

Parts List			
ITE	QT	PART No.	DESCRIPTION
1	1	BA5083	Actuator Shaft End Interface
2	1	BA5123	Valve Bucket Adapter
3	1	BA5125	Arrow Open Close
4	1	BA5151	150Nm Hyd. Actuator
5	1	BA5176	Valve Bucket Half Adapter
6	1	BA5177	Rov Handle
7	1	BA5179	Cage for Actuator System
8	19	100759	Lock Washer
9	11	100118	Nut
10	9	100214	Countersunk Head
11	4	100594	Bolt
12	4	100535	Nut
13	8	100758	Serrated Lock Washer
14	2	101120	Bolt
15	1	101122	Bolt
16	1	100426	Anode
17	6	100714	Bolt
18	1	101124	Shackle G-2130
19	2	100003	Bolt

Note 1
 WEIGHT IN AIR: 44 KG
 WEIGHT IN SEA: 38 KG
 WP: 210 BAR
 HYD. OPEN TORQUE: 150Nm
 MECH. SHUT TORQUE: 130nm

01	8.5.2014	8-ASB (As-Built)		TBA	LAE	BNE
Rev.	Date	Reason for issue	Revision change	Made	Chk'd	Appr.

BLUE LOGIC

Dwg Scale:
 Dwg Proj:
 Dwg Format:
 A3

Drawing title:
 Hyd. Actuator

Drawing number:
 BA5173

Rev.
 01