
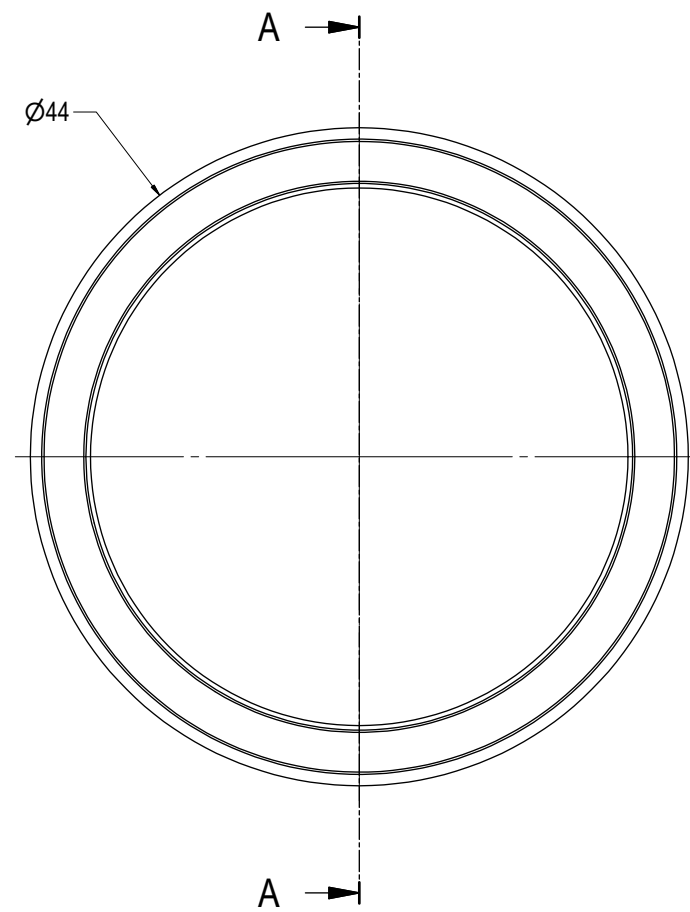
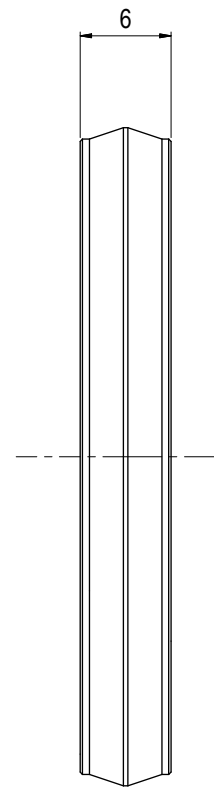


SECTION A-A

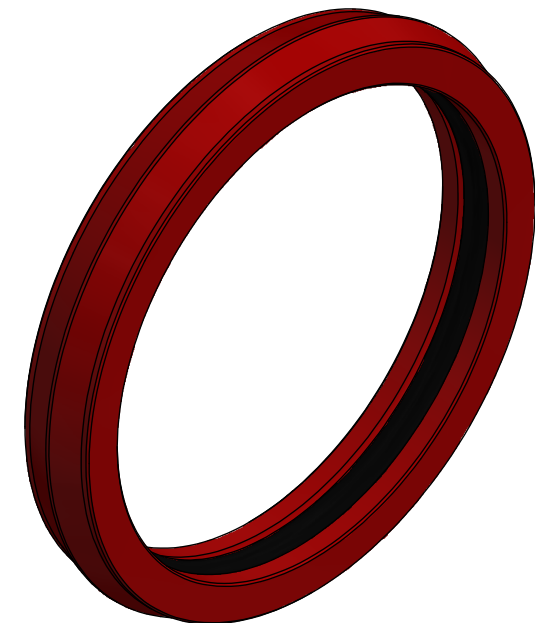

NOTE: 1
DESIGN CODE:
N/A

NOTE: 2
TECHNICAL CLASSIFICATION:
Article Type: 001-Hotstabs
Main Group: 1.00. Misc-Hotstab
Intermediate Group: 1.51.9. Spares
Sub Group: 1.51.152.1. Stab

NOTE: 3
INTERFACE INFORMATION:
Pressure Rating Bar: N/A
Material: HPU
Weight: 0 kg
Volume: 0 dm^3
Surface Area: 23 cm^2
Hydraulic: N/A
Mechanical: N/A
Electrical: N/A
Com. & Protocol: N/A

01	19.10.2011	8-ASB (As-Built)		vafhse		
Rev.	Date	Reason for issue	Revision change	Made	Chk'd	Appr.

BLUE LOGIC 

Dwg Scale:
NTS
Dwg Proj: 
Dwg Format:
A3

Drawing title:
Stab Seal

Drawing number:
100115

Rev.
01