

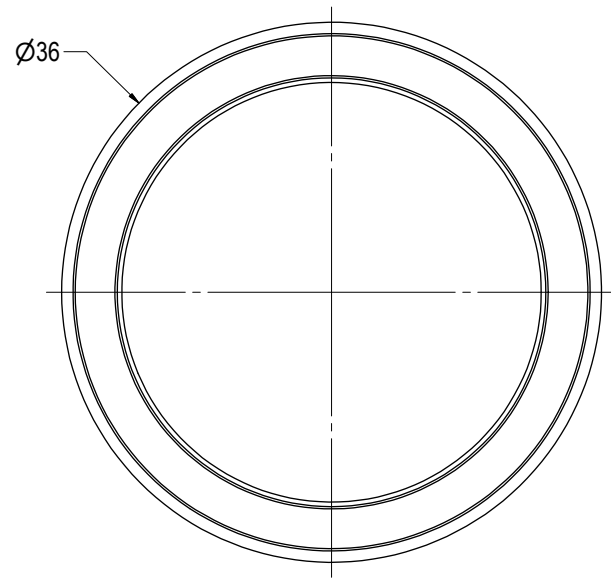


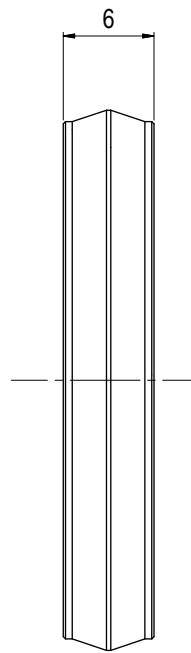

NOTE: 1
DESIGN CODE:
N/A

NOTE: 2
TECHNICAL CLASSIFICATION:
Article Type: 100-Purchased
Main Group: 100.03. Seals-Purchase
Intermediate Group: 100.22.09. Stab Seal
Sub Group: 100.22.57.02. HPU

NOTE: 3
INTERFACE INFORMATION:
Pressure Rating Bar: N/A
Material: HPU
Weight: 0 kg
Volume: 1,9 cm^3
Surface Area: 19 cm^2
Hydraulic: N/A
Mechanical: N/A
Electrical: N/A
Com. & Protocol: N/A

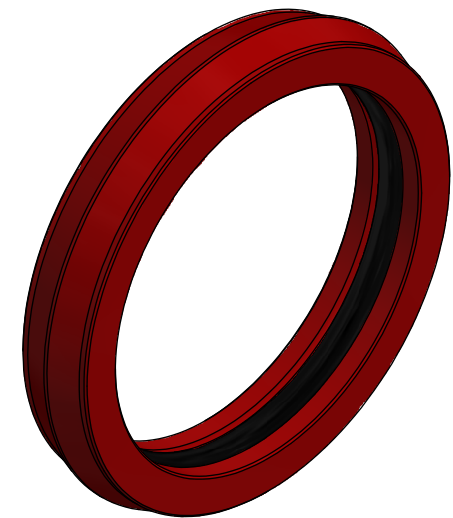

01	21.6.2017	8-ASB (As-Built)		WTJ	HNJ	WTJ
Rev.	Date	Reason for issue	Revision change	Made	Chk'd	Appr.



Dwg Scale: NTS	Drawing title: Stab Seal	
Dwg Proj: A3		
Dwg Format: A3	Drawing number: 100110	Rev. 01