



Parts List			
ITEM	QTY	PART No.	TITLE
1	1	103920	Cable FL FiberL=38m wHydralight 8 Pin wGisma

NOTE: 1
DESIGN CODE:
API 17F

NOTE: 2
TECHNICAL CLASSIFICATION:
Article Type: 017-Drone Charging
Main Group: 17.01. UID Charge Station
Intermediate Group: 17.80.07. Cables Jumpers
Sub Group: 17.80.387.02. Fibre FL

NOTE: 3
INTERFACE INFORMATION:
Pressure Rating Bar: N/A
Material: Generic
Weight: 6,1 kg
Volume: 6,11 dm^3
Surface Area: 9219 cm^2
Hydraulic: N/A
Mechanical: N/A
Electrical: N/A
Com. & Protocol: N/A

NOTE: 4
ADDITIONAL INFORMATION:
35m fibre-optic jumper with Hydralight ROV connector in one end and Gisma panel mounted connector in the other end. A fibre-optic splice box installed 3m from the Gisma connector.
8 fibre-optic lines positioned inside the oil-filled hose. All metallic parts in Super Duplex and Titanium suitable for permanent installation. Equipped with cable grip for protection of jumper.

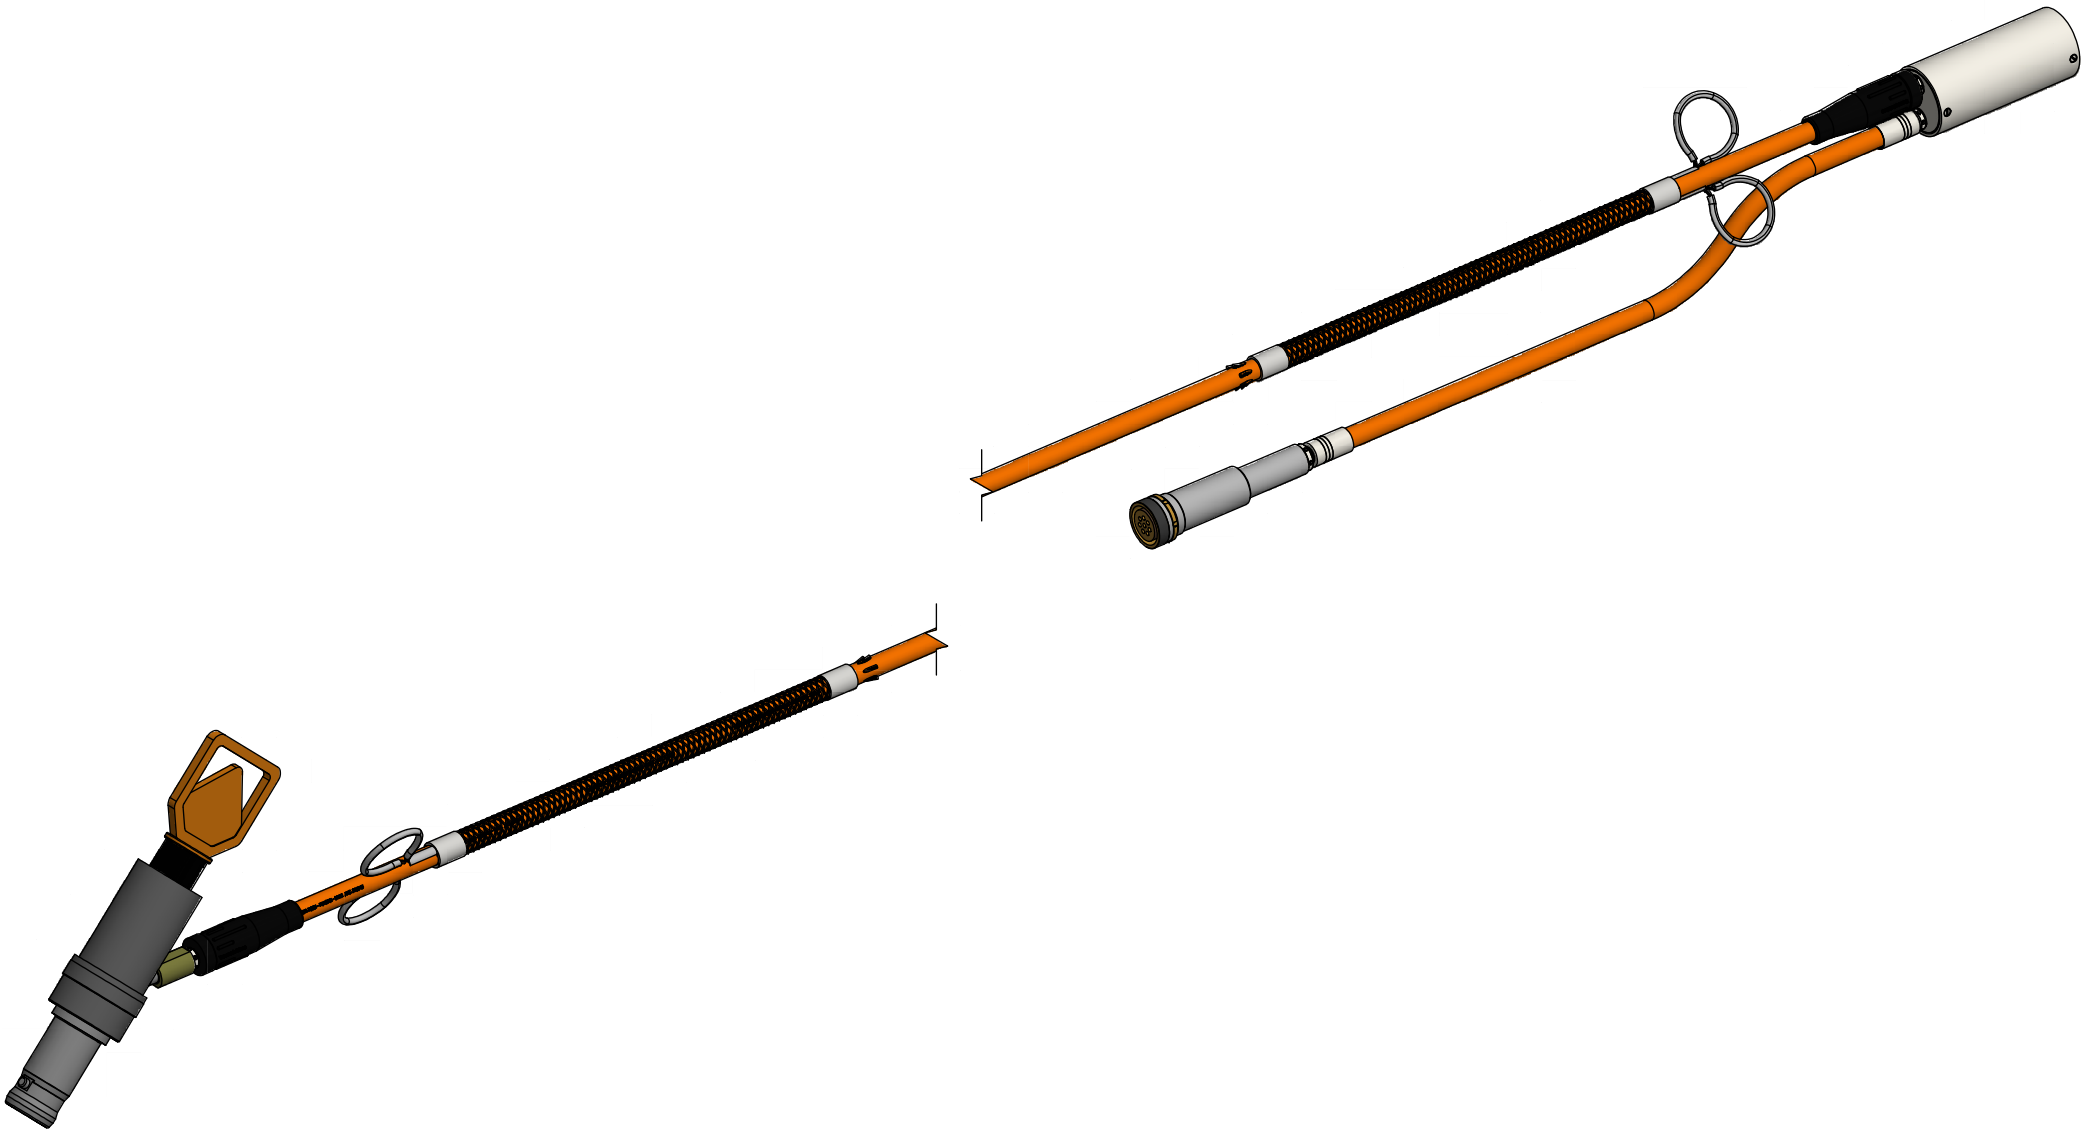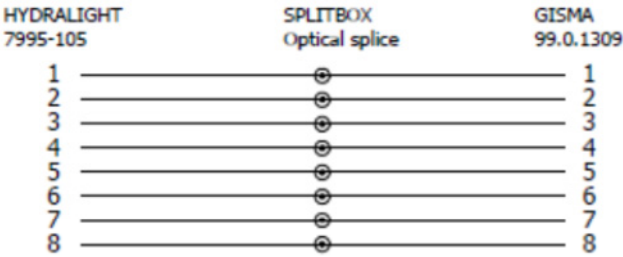

							<div>BLUE LOGIC</div> 	Dwg Scale: NTS	Drawing title: Cable FL FiberL=38m wHydralight 8 Pin wGisma
								Dwg Proj: 	
								Dwg Format: A3	
02	30.3.2021	8-ASB (As-Built)		WTJ	HSE	EKJ			Drawing number: 103920
01	27.3.2020	8-ASB (As-Built)		WTJ	LGH	N/A			
Rev.	Date	Reason for issue	Revision change	Made	Chk'd	Appr.			Rev. 02