

NOTE: 1 DESIGN CODE:

N/A

NOTE: 2


TECHNICAL CLASSIFICATION:


Article Type: 099-Project Engineering
Main Group: 99.1 Mechanical
Intermediate Group: 99.38.4 Piping
Sub Group: 99.38.97.4. Piping

NOTE: 3

INTERFACE INFORMATION:
Pressure Rating Bar: N/A
Material: N/A
Weight: 451,285 kg
Volume: 59,434 dm^3
Surface Area: 55686,239 cm^2

Hydraulic: N/A
Mechanical: N/A
Electrical: N/A
Com. & Protocol: N/A

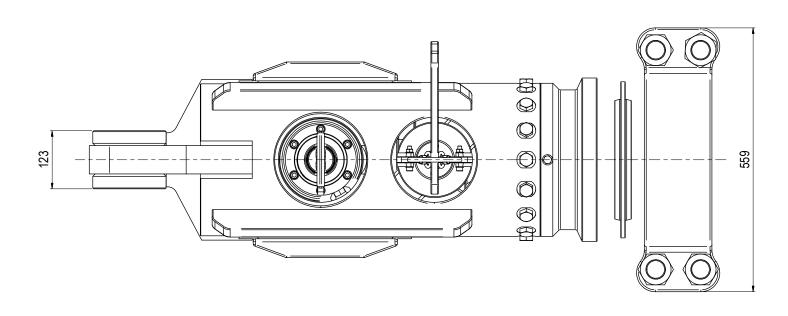

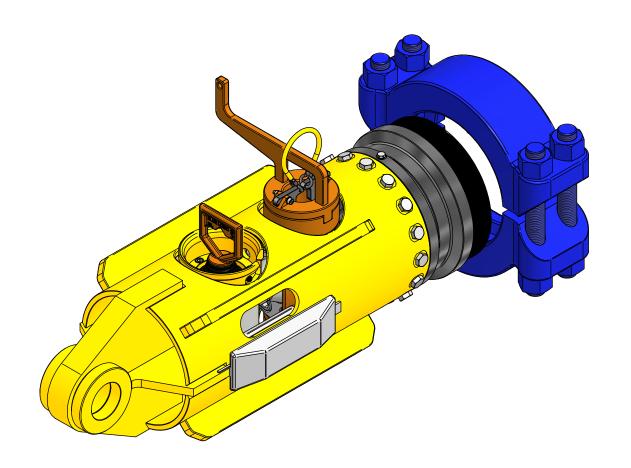

05	27.2.2012	As Built		LGH	EKJ	LGH
04	4 22.2.2012 Issued for Information			LGH	NA	NA
03	17.02.2012	Issued for Production		LGH	EKJ	LGH
Rev.	Date	Reason for issue	Revision change	Made	Chk'd	Appr.



Dwg Scale: NTS Dwg Proj:	Drawing title: 10" PLET SYSTEM	
Dwg Format: A3		
	Drawing number: BA2252	Rev. 05