


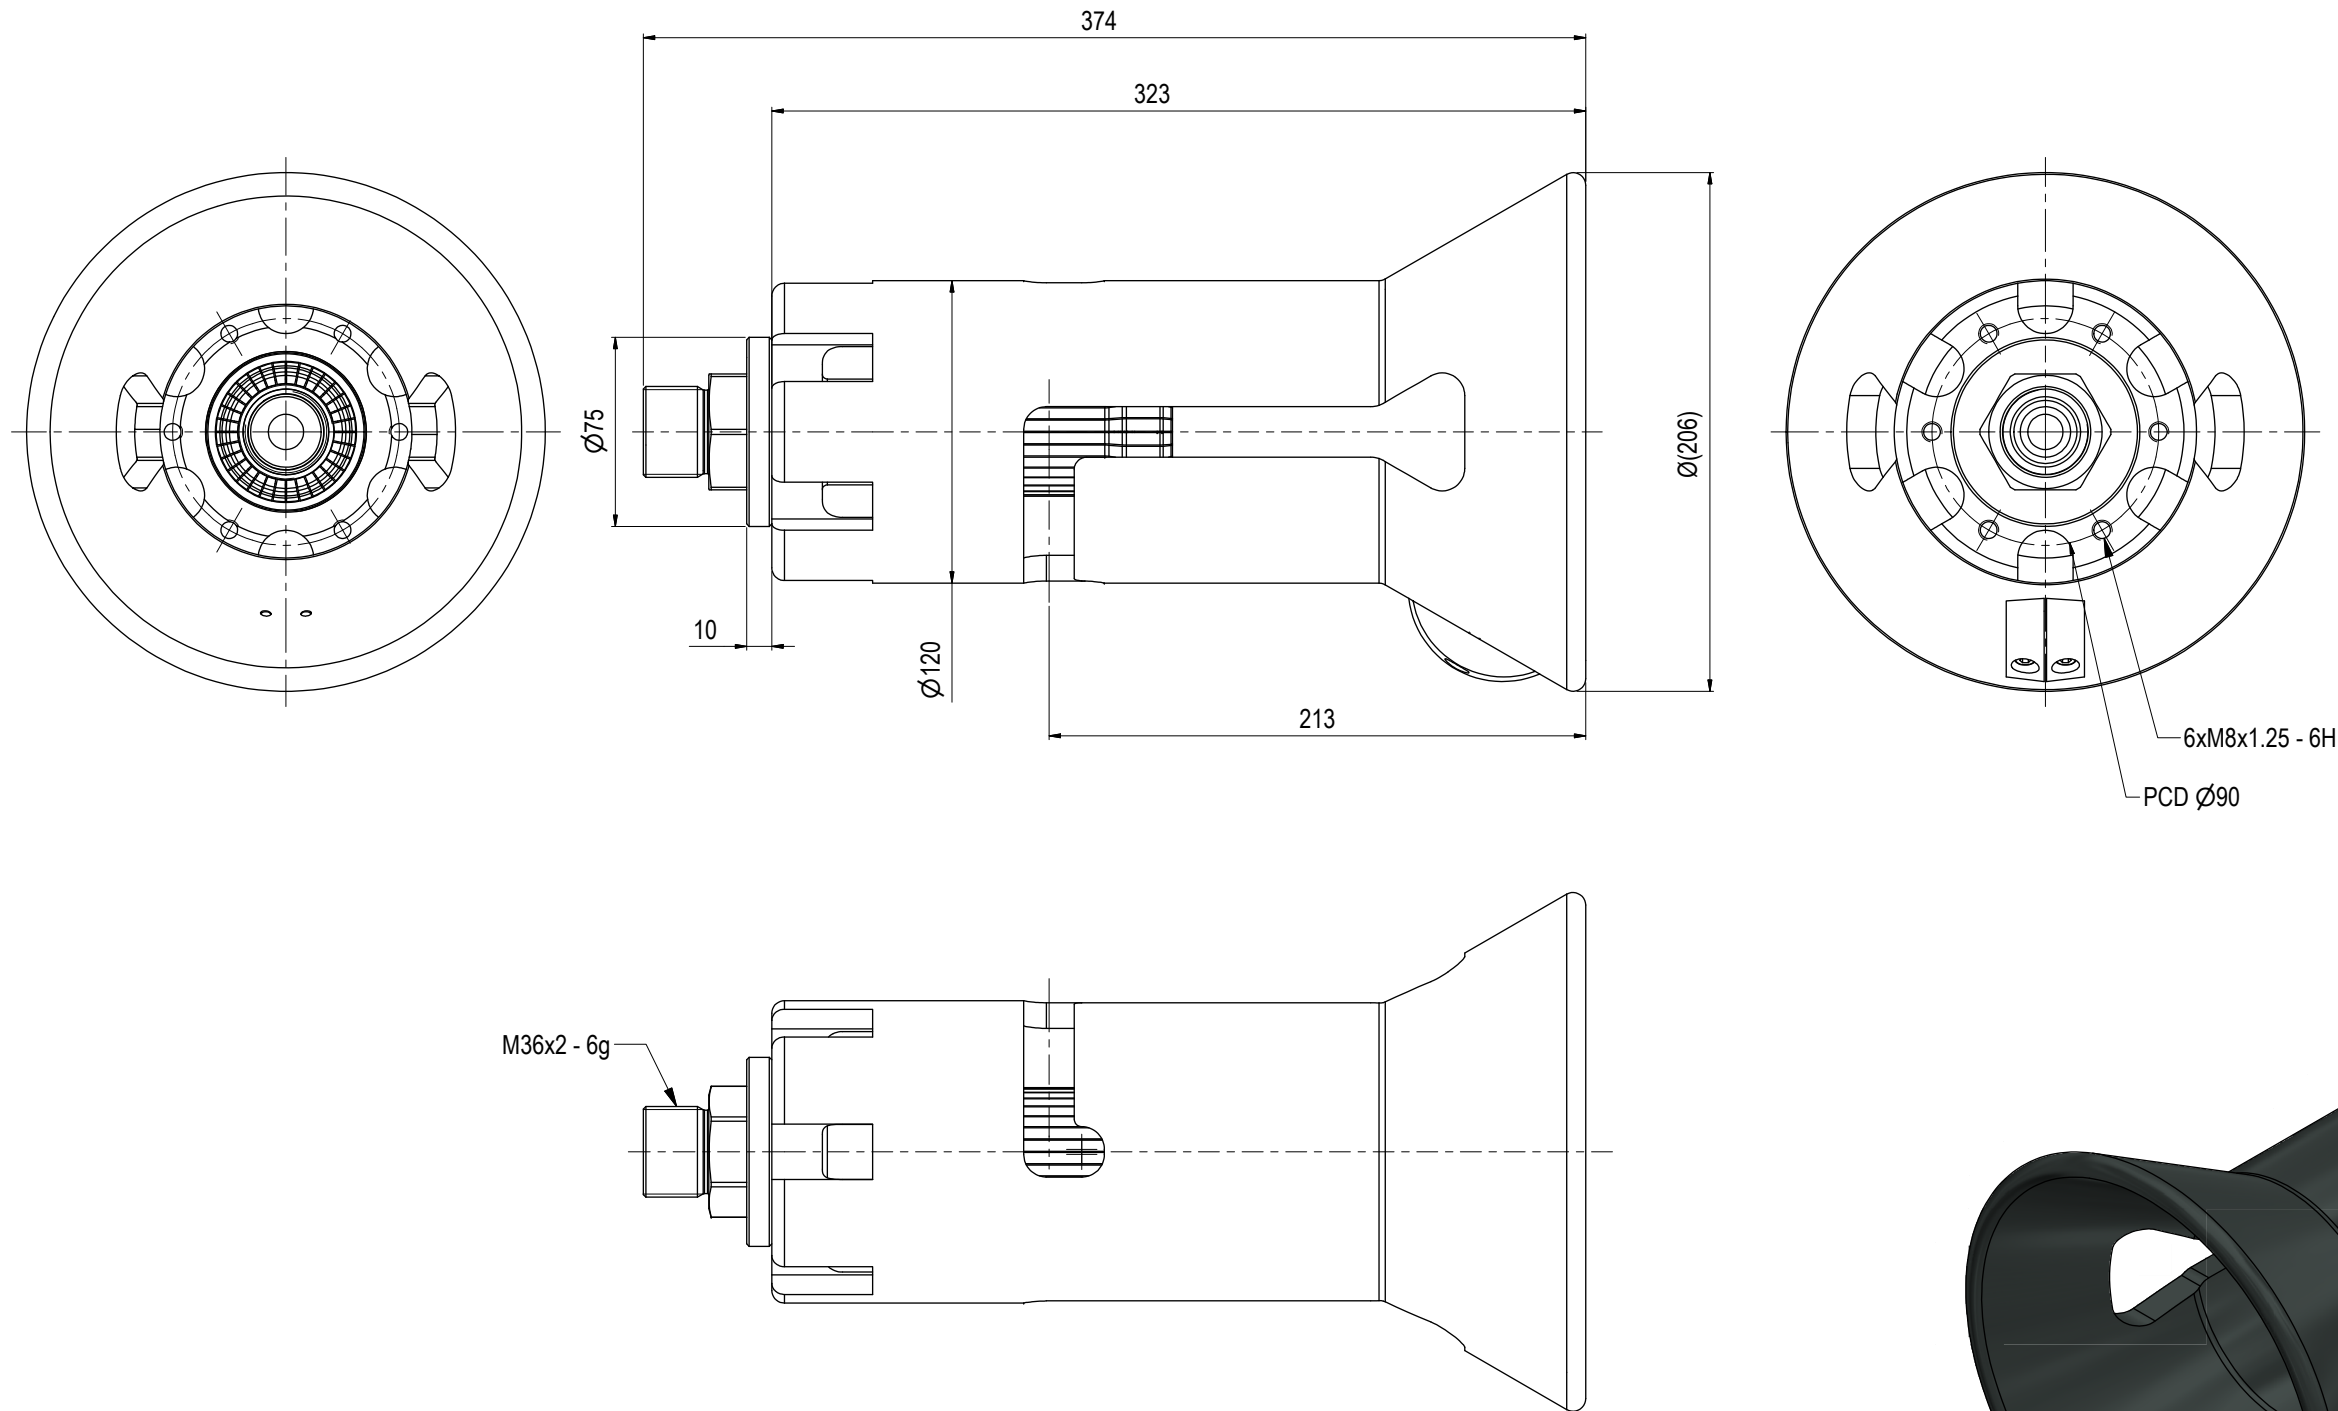

NOTE: 1
DESIGN CODE:
N/A

NOTE: 2
TECHNICAL CLASSIFICATION:
Article Type: 010-Quick Con. System
Main Group: 10.1. Single Line Quick Connector
Intermediate Group: 10.1001.3. High Pressure
Sub Group: 10.1001.205.1. Male

NOTE: 3
INTERFACE INFORMATION:
Pressure Rating Bar: 2000
Material: N/A
Weight: 5,4 kg
Volume: 1491 cm³
Surface Area: 3616 cm²
Hydraulic: N/A
Mechanical: N/A
Electrical: N/A
Com. & Protocol: N/A

6xM8x1.25 - 6H
PCD Ø90



Rev.	Date	Reason for issue	Revision change	Made	Chk'd	Appr.
02	9.9.2014	8-ASB (As-Built)	Added Anodes	HLG	WTJ	HLG
01	21.2.2014	9-IFU (Issued for Use)		HLG	WTJ	HLG

BLUE LOGIC

Dwg Scale:
NTS
Dwg Proj:
Dwg Format:
A3
Filename:
BA4946.idw

Drawing title:
1" 15k QC Rec

Drawing number:
BA4946

Rev.
02