Parts List			
ITEM	QTY	PART No.	TITLE
1	1	103963	Cable Jumper L=70m w2x4 Pin Tronic 4mm2

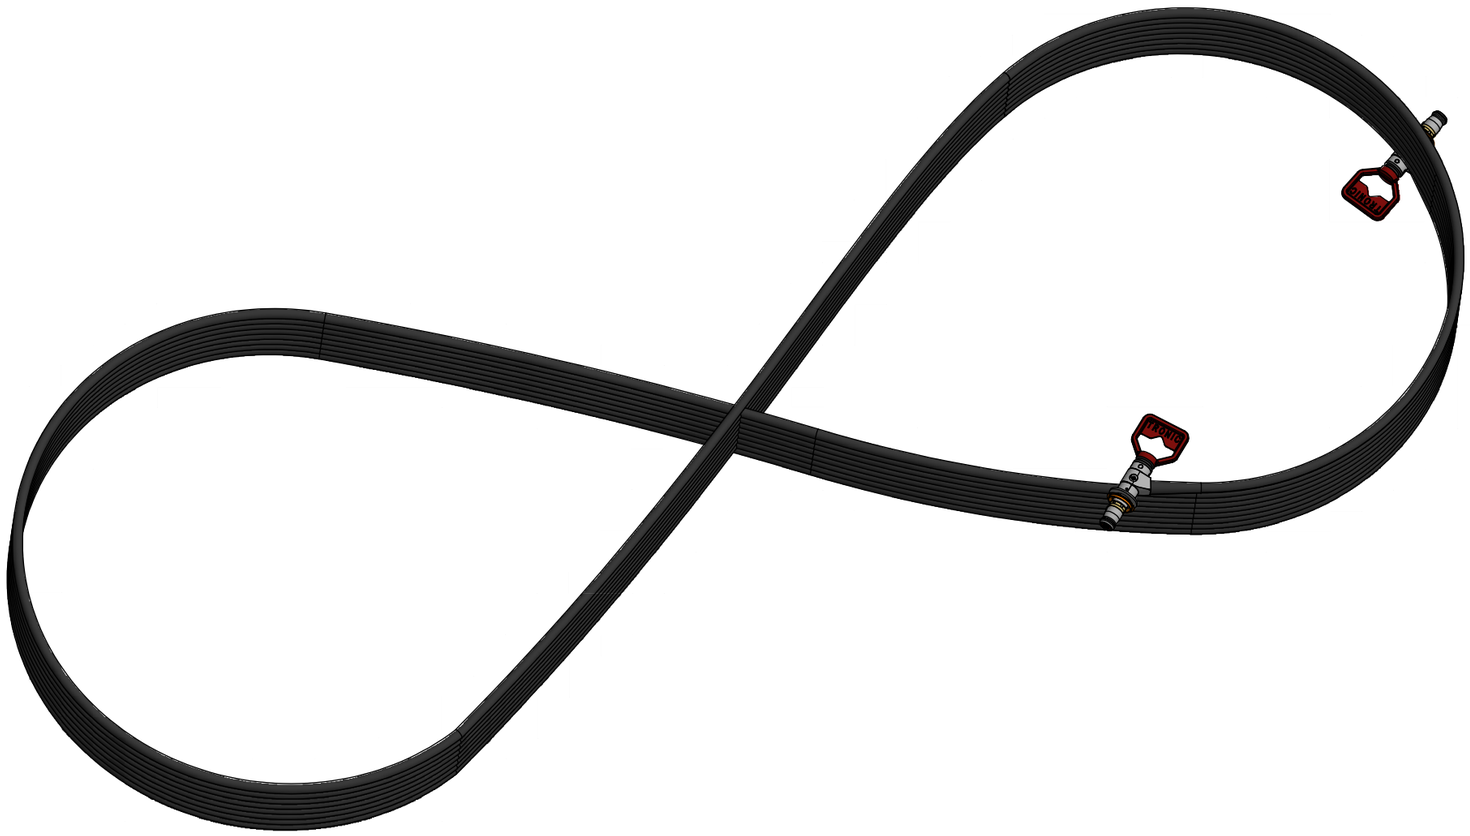

NOTE: 1
DESIGN CODE:
API 17F

NOTE: 2
TECHNICAL CLASSIFICATION:

Article Type:	017-Drone Charging
Main Group:	17.01. UID Charge Station
Intermediate Group:	17.80.07. Cables Jumpers
Sub Group:	17.80.387.05. Power Jumper

NOTE: 3
INTERFACE INFORMATION:

Pressure Rating Bar:	N/A
Material:	Generic
Weight:	70 kg
Volume:	39,31 dm^3
Surface Area:	62930 cm^2
Hydraulic:	N/A
Mechanical:	N/A
Electrical:	N/A
Com. & Protocol:	N/A

NOTE: 4
ADDITIONAL INFORMATION:
70m electrical power jumper with 4-pin Tronic wet mate connectors for ROV connection and disconnection.4 off wires with AWG 12 positioned inside the oil-filled hose. All metallic parts in Super Duplex and Titanium suitable for permanent installation. Equipped with cable grip for protection of jumper.

Rev.	Date	Reason for issue	Revision change	Made	Chk'd	Appr.
01	30.3.2021	8-ASB (As-Built)		WTJ	HSE	EKJ

BLUE LOGIC

Dwg Scale: NTS
Dwg Proj:
Dwg Format: A3

Drawing title: Cable Jumper L=70m w2x4 Pin Tronic 4mm2

Drawing number: 103963

Rev. 01